T. 39 S., R. 5 E. W.M.

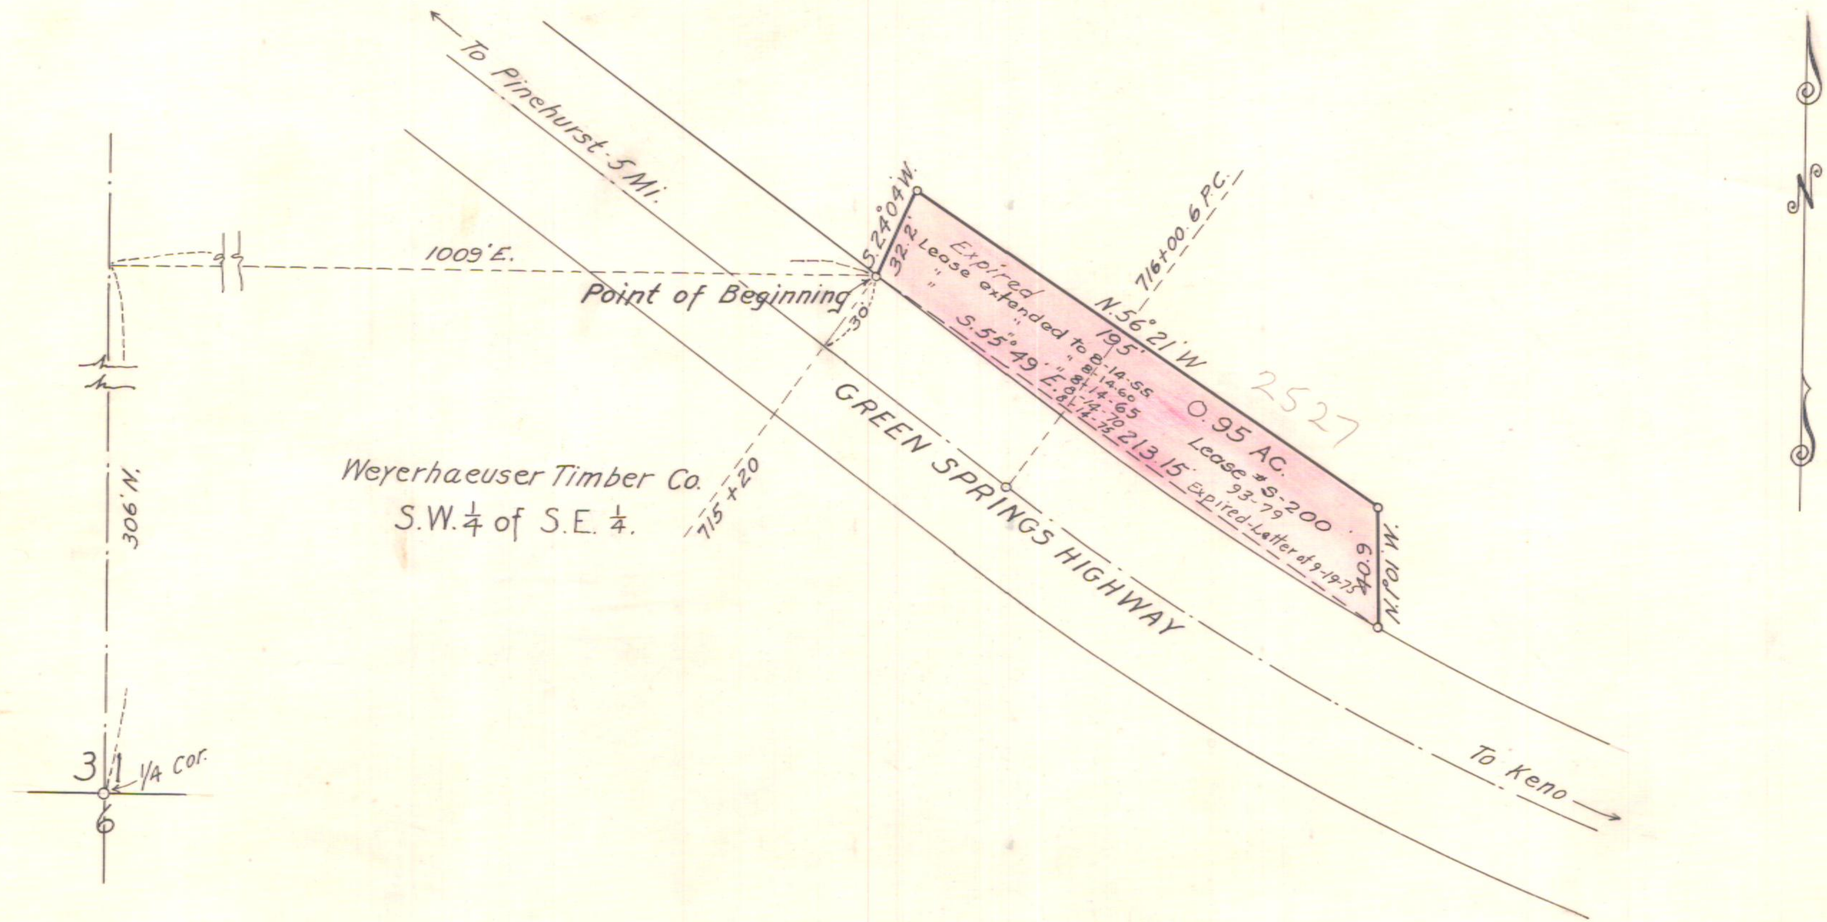

Lease extended to Aug. 14, ~~1960~~ 1965
Lease extended to Aug. 14, ~~1945~~ ~~1950~~ ~~1955~~
Lease expires Aug. 14, ~~1940~~

OREGON STATE HIGHWAY DEPARTMENT	
Leased From	Weyerhaeuser Timber Co.
For	STOCK PILE SITE
Highway	Green Springs
County	Klamath
Scale 1" = 50'	Date Sept. 1930

3B-25-14 (400')